

Approvals

NOTE:

Where a boundary is shown along a river or road it follows the middle line of the physical river or legal road unless shown otherwise

All Seaward boundaries follow ~~the high water~~ but cross the mouths of all rivers, streams, inlets and estuaries unless shown otherwise.

This Ward includes all adjacent islands and islets although only the larger ones are shown

This Ward includes all adjacent islands within the 12 mile limit and above the mean ~~high~~ low water springs mark, that are not shown on this plan. Refer to letter dated 14 September 1993 on file 6215-01 folio 40.

7/10/93

Q. Johns
Acting Chief Surveyor

I certify that this plan renders the boundary capable of identification under Section 101M(3)(b) Local Government Act 1974.

W. H. H. H. H.
Chief Surveyor

Total Area 19.0

Comprised in

Registered Surveyor and holder of an annual practicing certificate who acts as a registered surveyor to section 25 of the Survey Act 1968. I hereby certify that this plan has been prepared in accordance with the provisions of the Survey Regulations 1972 in any regulations made in accordance with the Survey Regulations 1972 in any regulations made in accordance therewith.

of this day

Signature

of this day

Signature

Approved as to alteration to seaward boundary, as amended by Gaz 1996 p4113.

W. H. H. H. H.
Chief Surveyor

Approved for Gazette Purposes

7 / 6 / 89

S. Weller
Acting Chief Surveyor



Deposited this day of 19

District Land Registrar

File

Instructions

SO 11492

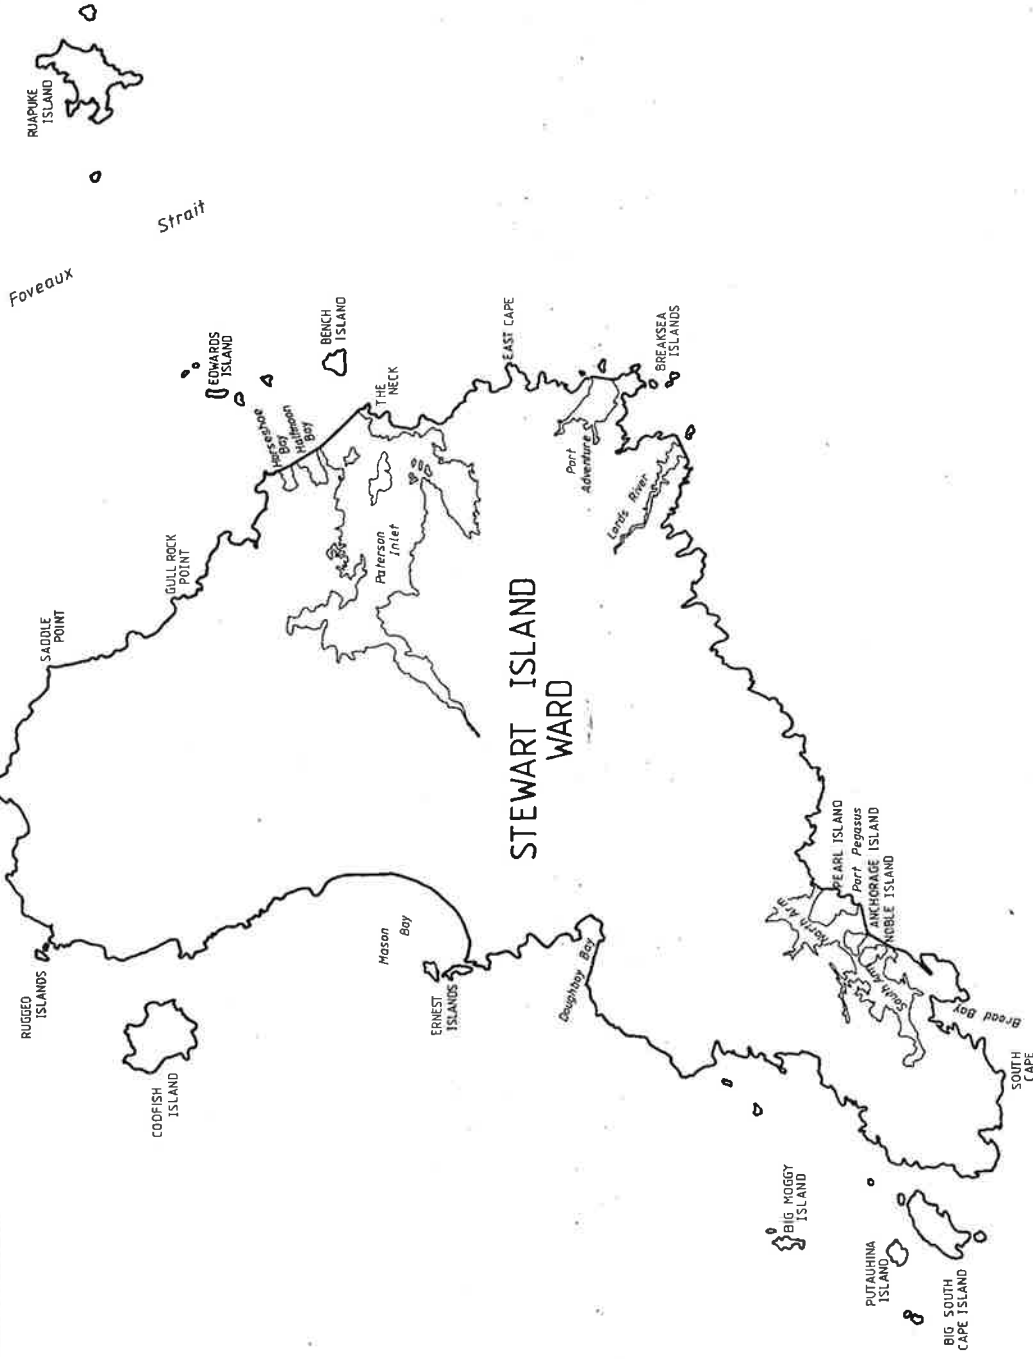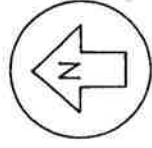

LAND DISTRICT SOUTHLAND
Survey Blk. & Dist.
NZMS 261 Sheet Record Map No.

STEWART ISLAND WARD

TERRITORIAL AUTHORITY SOUTHLAND DIST.
Prepared by Survey & Land Information
Scale 1: 250 000 Date JUNE 1989

