

WESTERN
 CONSTITUENCY
 SO 386355

HOKONUI
 CONSTITUENCY
 SO 301282
 SO 386343

WAIKIWI
 CONSTITUENCY
 SO 11507

SOUTHERN
 CONSTITUENCY
 SO 301283



NOTES:
 For full description of Territorial Local Authority and adjoining Constituencies refer to plans shown.
 The seaward boundary is the outer limits of the Territorial Sea as defined by Section 3 of the Territorial Sea and Exclusive Economic Zone Act 1977.
 Bearings are in terms of New Zealand Map Grid.
 Adjoining Constituency boundary

Certified by the Local Government Commission that the boundary shown hereon is the same as the determination dated 27/03/2001 pursuant to Section 101K(1)(b) Local Government Act 1974.

[Signature] 1/6/01
 Chief Executive Officer
 Local Government Commission

Amended as per the Local Government Commission determination dated 2 April 2007 pursuant to Section 19R(1)(b) Local Electoral Act 2001.

[Signature] 5/6/07
 Chief Executive Officer
 Local Government Commission

I certify that this plan renders the boundary capable of identification under section 19Y(3)(b) Local Electoral Act 2001.

[Signature] 12/6/2007
 Approving Surveyor

Reference Plans SO's 11492, 11507, 12075, 12078, 301282, 301283


Examined Correct

I certify that this plan renders the boundary capable of identification under Section 101M(3)(b) Local Government Act 1974.

[Signature] 27/6/01
 Chief Surveyor

File T06/10715
 Received 13/6/01
 Instructions

SO 301281

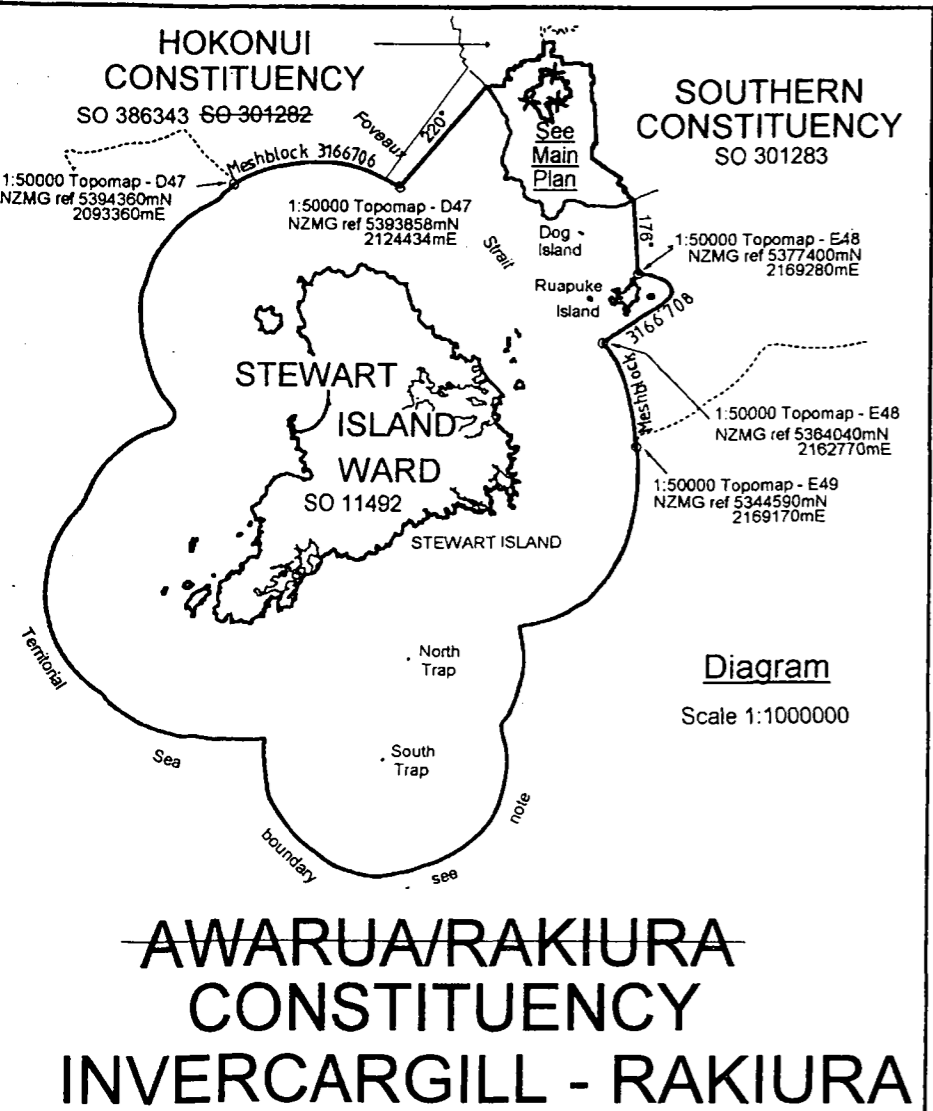

~~AWARUA/RAKIURA~~
~~CONSTITUENCY~~
~~INVERCARGILL - RAKIURA~~
~~CONSTITUENCY~~
 DESCRIPTIVE PLAN

LAND DISTRICT SOUTHLAND

INVERCARGILL - RAKIURA
~~AWARUA/RAKIURA~~ CONSTITUENCY

TERRITORIAL AUTHORITY Southland District
 Invercargill City
 Prepared by ANDERSEN & ASSOCIATES LTD
 Scale 1:125000 Date: May 2001 10715